

NOTICE OF EXEMPTION

(City CEQA Guidelines)

Submission of this form is optional. The form shall be filed with the County Clerk, 12400 Imperial Highway, Norwalk, CA 90650, pursuant to Public Resources Code Section 21152(b). Pursuant to Public Resources Code Section 21168(d), the filing of this notice starts a 35-day statute of limitations on Court challenges to the approval of the project. Failure to file the notice results in the statute of limitations being extended to 180 days.

LEAD CITY AGENCY AND ADDRESS: Los Angeles Department of Water and Power (LADWP) 111 N. Hope Street, Room 1044 Los Angeles, CA 90012	COUNCIL DISTRICT # 7
---	------------------------------------

PROJECT TITLE Tujunga Pump Station Expansion Project	LOG REFERENCE
--	----------------------

PROJECT LOCATION
 The project is located at the existing Tujunga Pump Station, which lies west of the 5 Freeway and 170 Highway junctions. The Tujunga Pump Station is approximately 18 miles northeast of the center of downtown Los Angeles. The project is at the address of 8801 Arleta Avenue, Pacoima, California 91331.

DESCRIPTION OF NATURE, PURPOSE, AND BENEFICIARIES OF PROJECT:
 The LADWP proposed project will install two new pumping units inside Tujunga Pump Station (station), which is in an enclosed building originally constructed in the early 1990's. These additional pumps will be used to improve the station's reliability and resiliency by functioning as stand-by or back-up units that can be operated when existing pumps are out of service for maintenance and repair. The system will continue to help maintain reliable water flow to the San Fernando Valley service areas, and to the reservoirs and tanks in the central area of Los Angeles.
 Project will consist of installing two additional skid mounted horizontal split-case pumps inside the Tujunga Pump Station. (See new pumps represented in dashed marks in the attached floor plan.)
 The following additional infrastructure will be installed within an approximately 80' x 40' area inside the station:

- New aboveground piping between the pumps and station suction & discharge piping,
- New valves for pump isolation & control,
- Demolition of two existing concrete 8'x10' pads and fabrication of two new pump foundations,
- Pulling new wiring to existing Power and Control cabinets through existing conduit.

The installation period with testing will approximately take 30 weeks.

CONTACT PERSON Nancy Chung	AREA CODE TELEPHONE NUMBER EXT. 213 367-0404
--------------------------------------	--


EXEMPT STATUS:
 CEQA Guidelines Article 19 Categorical Exemption, Section 15301 Class 1 Existing Facilities and 15303, Class 3, New Construction/Conversion of Small Structures.

JUSTIFICATION FOR PROJECT EXEMPTION:
 In accordance with the California Environmental Quality Act (CEQA) it has been determined that the placement of the pump system is a minor alteration of existing public facility involving negligible or no expansion of existing use as allowed for under Class 1 Categorical Exemption as describe in Section 15302 of the CEQA Guidelines. Additionally, the project is consistent with the construction and location of limited new, small facilities or structures; installation of small new equipment and facilities in small structures, and thus exempted pursuant to Class 3 Categorical Exemption as described in Section 15302 of the CEQA Guidelines.


IF FILED BY APPLICANT, ATTACH CERTIFIED DOCUMENT OF EXEMPTION FINDING

SIGNATURE <i>Nancy Chung for</i> Charles C. Holloway	TITLE: Manager of Environmental Planning and Assessment	DATE 10/14/20
FEE: \$75.00	RECEIPT NO.	REC'D BY
		DATE

D4755-M-301C

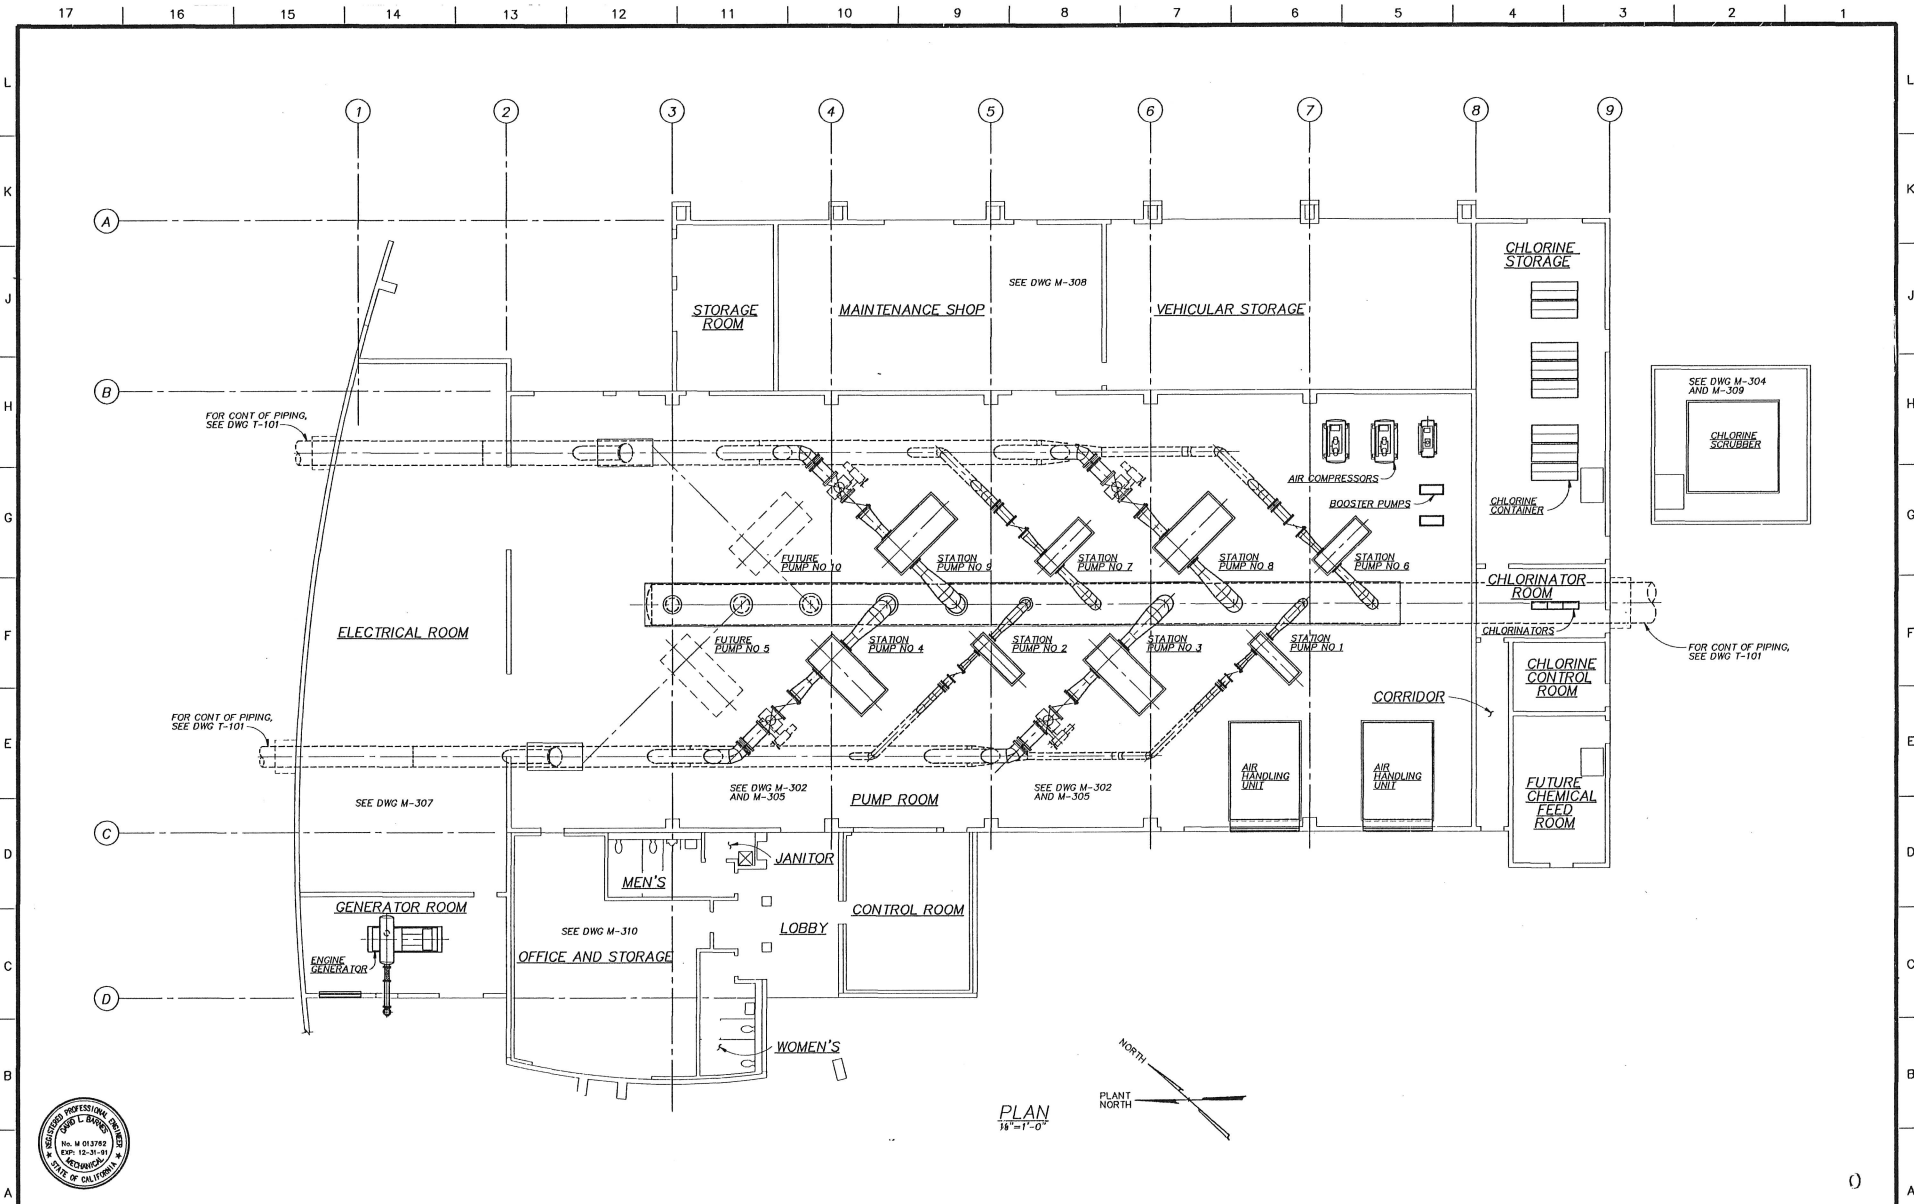

PLAN
1/8"=1'-0"

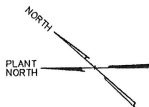

VERIFY SCALES		REVISIONS		REFERENCES		SCALE		DATE		APPROVED		DATE	
NUMBER	DATE	INITIALS	LOC.	DESCRIPTION	APP'YS								
1	10/93	K.E.		AS CONSTRUCTED RECORD DRAWINGS				1/8"=1'-0"	8-90	DESIGNER			
										ASSIST.			
										DRAWN			
										CHECKED			
										RECOMMENDED			

TUJUNGA WELL FIELD PROJECT
TUJUNGA PUMPING STATION COMPLEX
 PUMP STATION
 FLOOR PLAN
 DEPARTMENT OF WATER AND POWER
 CITY OF LOS ANGELES
 SOURCE NUMBER
D4755-M-301C

CH2M HILL